

# GOVERNMENT CAMP FIRE STATION

## Renovation - Rebid

### Village of Government Camp, Oregon

#### OWNER

Hoodland Fire District #74  
69634 E. Highway 26  
Welches, Oregon 97067  
T: (503)622-3256  
F: (503)622-3125

#### CONSULTANTS

#### Architect

KEYSTONE Architecture Planning & Project Management LLC  
12020 SE Idlemann Road  
Portland, Oregon 97086  
Contact: Blane Skowhede  
Email: [blane@keystone-architecture.com](mailto:blane@keystone-architecture.com)


#### Structural Engineer

Associated Consultants Inc.  
100 East 13th Street, Suite 10  
Vancouver, WA 98660  
Phone: (503) 380-0460 Fax: (503) 380-0459  
Contact: Babrak Amiri  
Email: [babrak@aciengineers.com](mailto:babrak@aciengineers.com)

#### LEGAL DESCRIPTION

Federal Land under administration of the US Forest Service

#### ARCHITECTURAL SYMBOLS

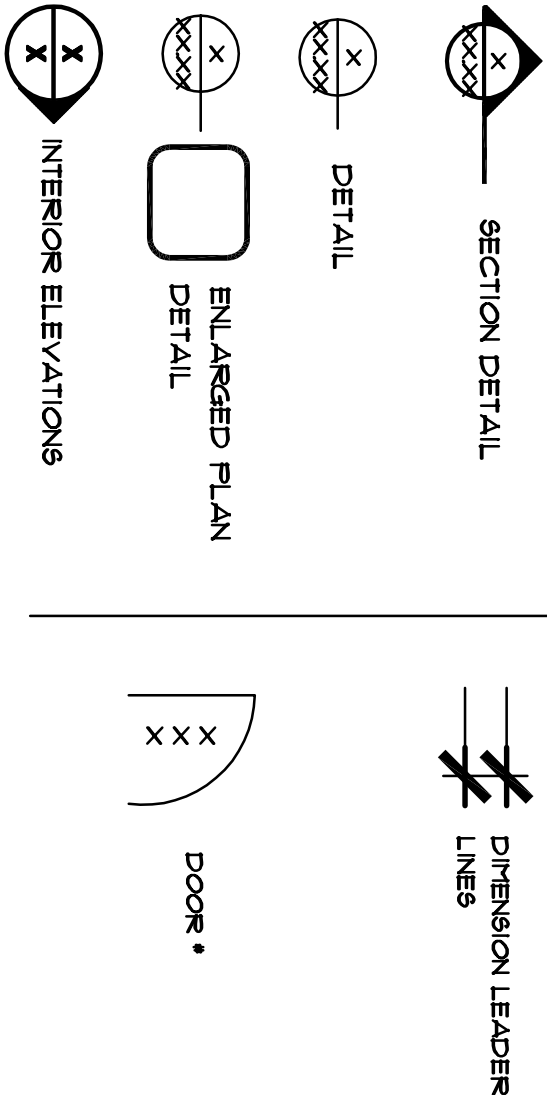

#### RECORD DRAWINGS

Limited.

#### DEFERRED SUBMITTALS

Mechanical Design  
Electrical Design  
Plumbing Design  
Fire Sprinkler Design

#### TABLE OF CONTENTS

|       |   |
|-------|---|
| A0.00 | PROJECT INFORMATION, SITE PLAN                    |
| A1.01 | CODE PLAN, CODE REVIEW                            |
| A1.02 | DOOR SCHEDULE, SIGN SCHEDULE                      |
| A2.01 | GROUND FLOOR PLAN                                 |
| A3.01 | SOUTH ELEVATION, EAST ELEVATION                   |
| A3.02 | NORTH ELEVATION, WEST ELEVATION                   |
| A4.01 | BUILDING SECTION, PARTIAL REFLECTED CEILING       |
| A5.01 | ENLARGED TOILET ROOM 105 PLAN & ELEV'S.           |
| A5.02 | ENLARGED KITCHEN PLAN & ELEV'S.                   |
| A5.03 | ENLARGED TOILET ROOM 109 PLAN & ELEV'S.           |
| A6.01 | WINDOW, ARCHITECTURAL DETAILS                     |
| A7.01 | PARTIAL REFLECTED CEILING PLAN                    |
| A8.01 | EXTERIOR BUILDING SIGN                            |
| S1.01 | STRUCTURAL GENERAL NOTES, CANOPY PLANS, & DETAILS |
| S1.02 | SCHEDULES   |
| S2.01 | FOUNDATION PLAN                                   |
| S2.02 | ROOF FRAMING PLAN                                 |
| S3.01 | FOUNDATION DETAILS                                |
| S4.01 | FRAMING DETAILS                                   |
| S5.01 | BUILDING SIGN STRUCTURE                           |

#### PROJECT DESCRIPTION


The project is a renovation of an approximately 3300 square foot single story fire station built in the 1980's. The building is owned by Hoodland Fire District while the land is owned by the Federal government. Most of the project is interior work. ADA improvements include reconstructing one of the two toilet/shower rooms and revising the kitchen plan.

Mechanical improvements are minimal. Electrical improvements include modifying lamping in existing luminaires. An NFPA 13 fire sprinkler will be installed.

Exterior work includes canopy structures outside the Sleeping Rooms windows.

Site work is mainly limited to a new waterline to supply the fire sprinkler system.

Project alternates include new metal roofing, exterior painting, generator automatic transfer switches and motorized louver, fans to remove diesel exhaust from the apparatus bays, and flooring in the sleeping rooms.

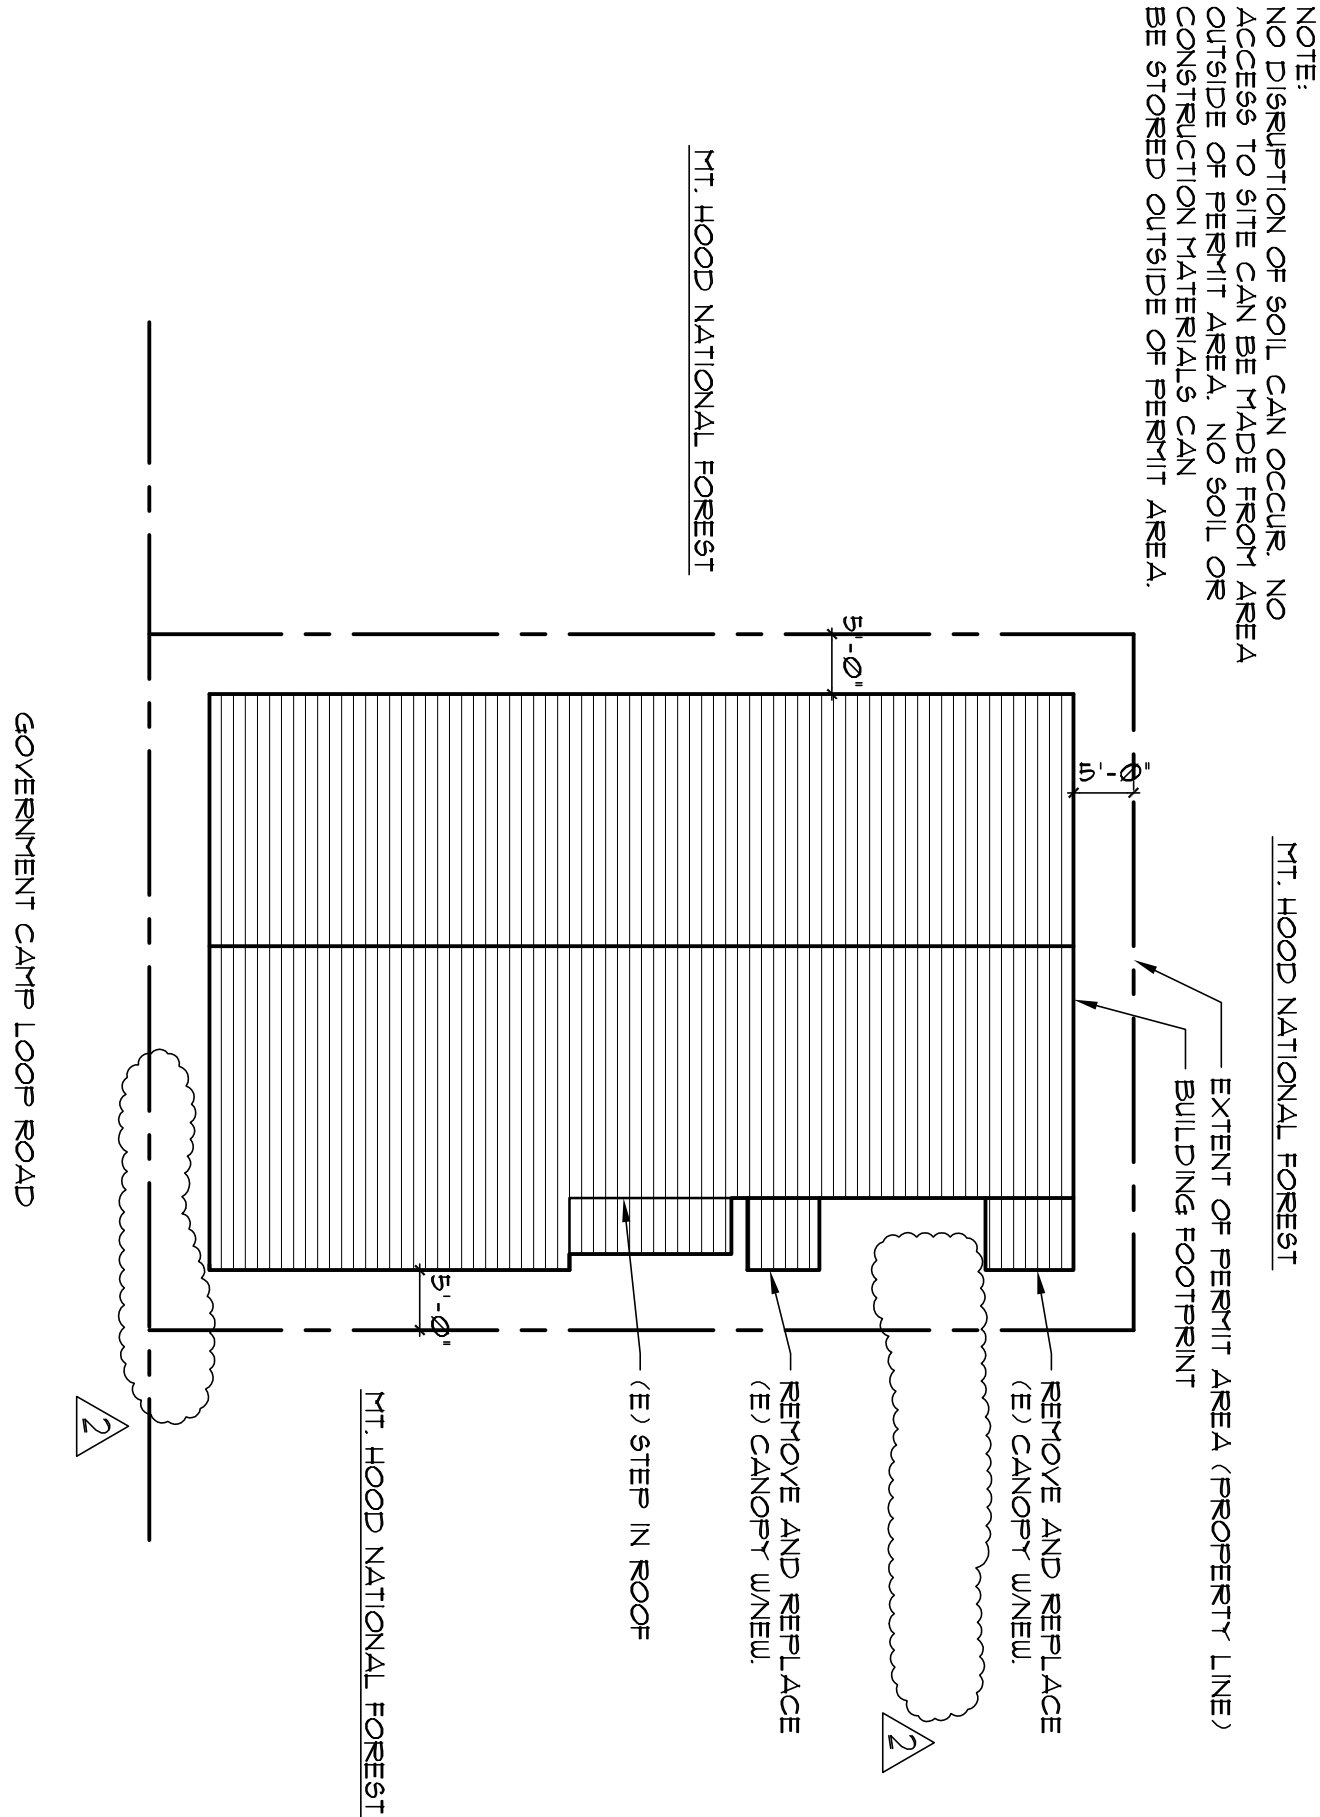

#### SITE PLAN




This document and the ideas and designs incorporated herein is an instrument of service of Blane Skowhede, Registered Architect and Project Management. KEYSTONE retains all common law, statutory and other reserved rights in this instrument. No part hereof, this document shall not be used in whole or in part for any other project without the express written permission of KEYSTONE Architecture Planning and Project Management.

Government Camp Fire Station  
Renovation - Rebid  
Government Camp Loop Road  
Government Camp, Oregon

**KEYSTONE**  
ARCHITECTURE PLANNING  
AND PROJECT MANAGEMENT  
12020 SE IDLEMAN ROAD, PORTLAND, OR 97086  
PHONE: (503) 761-1562 FAX: (503) 762-2534

|                 |          |
|-----------------|----------|
| REVISION        | DATE     |
| 1               | 12/12/18 |
| APPROVED: BWS   |          |
| DRAWN BY:       |          |
| SCALE: AS SHOWN |          |
| DATE: 12/9/17   |          |
| JOB: 17-102     |          |
| FILE:           |          |

A0.00

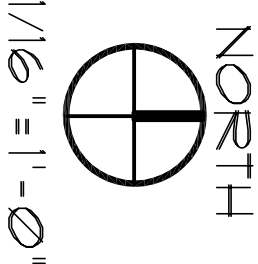

© KEYSTONE ARCHITECTURE